

FIELD
ENGINEERING CO., INC.
CONSULTING ENGINEERS

11D Industrial Drive, P.O. Box 1178
Mattapoisett, Massachusetts 02739
Telephone: (508) 758-2749
Facsimile: (508) 758-2849

March 21, 2014
Project No. 1646

Ms. Sarah Porter, Agent
New Bedford Conservation Commission
133 William Street
New Bedford, MA 02740

The Crocker Building
Four Court Street, Suite 104
Taunton, Massachusetts 02780
Telephone: (508) 824-9279
Facsimile: (508) 824-9276

RE: Request for Certificate of Compliance – DEP File No. SE 49-642
Multilayer Coating Technologies, c/o Watermill Group
50 Phillips Road, New Bedford, MA

Dear Ms. Porter:

Enclosed please find two (2) copies of record plans entitled, "Record Drawing", prepared by Field Engineering Co. Inc. for Multilayer Coating Technologies, dated 3/21/14 with attached WPA Form 8A – Request for Certificate of Compliance for your review and approval.

We have completed a review of the above referenced project for compliance with the following documents:


- Order of Conditions SE 49-642, issued by the New Bedford Conservation Commission to Multilayer Coating Technologies, c/o Watermill Group, dated 1/25/10 and the associated plans of record.


As we discussed, the annual maintenance of the woody vegetation that had started to develop within this drainage ditch was never completed. The current owners are in the process of selling the property and we anticipate filing a new Notice of Intent on behalf of the new owners for a variety of site improvements to include the potential reconfiguration of this drainage ditch very shortly.

As you may recall, the current owners of the property did clean-up the ditch by removing sediment and silt from the bottom of the ditch in response to an enforcement action from the Commission in 2009. Currently the ditch is stabilized and functioning as designed. On behalf of the current applicant of record, we respectfully request a final Certificate of Compliance pursuant to M.G.L.c. 131 §40 to close out this Order of Conditions.

If you have any questions or require additional information, please contact me at (508) 758-2749.

Sincerely,
Field Engineering, Inc.

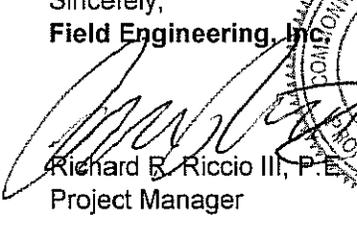
Richard B. Riccio III, P.E.
Project Manager

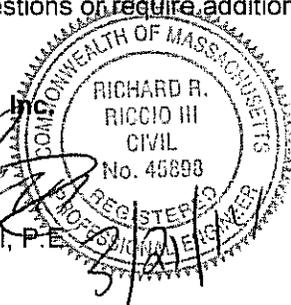

cc: Multilayer Coating Technologies



Massachusetts Department of Environmental Protection
Bureau of Resource Protection - Wetlands

DEP File Number:


WPA Form 8A – Request for Certificate of Compliance

SE 49-642
Provided by DEP

Massachusetts Wetlands Protection Act M.G.L. c. 131, §40
and the City of New Bedford Wetland By-Law

A. Project Information

Important:
When filling out forms on the computer, use only the tab key to move your cursor - do not use the return key.

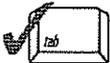

Upon completion of the work authorized in an Order of Conditions, the property owner must request a Certificate of Compliance from the issuing authority stating that the work or portion of the work has been satisfactorily completed.

1. This request is being made by:

Multilayer Coating Technologies, c/o Watermill Group
Name

One Cranberry Hill - 750 Marrett Road, Suite 401
Mailing Address

Lexington MA 02421
City/Town State Zip Code

(781) 398-9417
Phone Number

2. This request is in reference to work regulated by a final Order of Conditions issued to:

Multilayer Coating Technologies, c/o Watermill Group
Applicant

1/25/10 SE 49-642
Dated DEP File Number

3. The project site is located at:

50 Phillips Road New Bedford
Street Address City/Town

133 15
Assessors Map/Plat Number Parcel/Lot Number

4. The final Order of Conditions was recorded at the Registry of Deeds for:

Property Owner (if different)
Bristol, S.D.

County Book Page
106229


Certificate (if registered land)

5. This request is for certification that (check one):

the work regulated by the above-referenced Order of Conditions has been satisfactorily completed.

the following portions of the work regulated by the above-referenced Order of Conditions have been satisfactorily completed (use additional paper if necessary).
Siltation cleanup was completed and the ditch is stabilized. No additional maintenance work was
completed. (See attached letter for additional information)

the above-referenced Order of Conditions has lapsed and is therefore no longer valid, and the work regulated by it was never started.

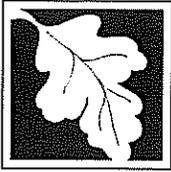

Massachusetts Department of Environmental Protection
Bureau of Resource Protection - Wetlands

DEP File Number:

WPA Form 8A – Request for Certificate of Compliance

SE 49-642

Massachusetts Wetlands Protection Act M.G.L. c. 131, §40
and the City of New Bedford Wetland By-Law

Provided by DEP

A. Project Information (cont.)

6. Did the Order of Conditions for this project, or the portion of the project subject to this request, contain an approval of any plans stamped by a registered professional engineer, architect, landscape architect, or land surveyor?


Yes

If yes, attach a written statement by such a professional certifying substantial compliance with the plans and describing what deviation, if any, exists from the plans approved in the Order.

No

B. Submittal Requirements

Requests for Certificates of Compliance should be directed to the issuing authority that issued the final Order of Conditions (OOC). If the project received an OOC from the Conservation Commission, submit this request to that Commission. If the project was issued a Superseding Order of Conditions or was the subject of an Adjudicatory Hearing Final Decision, submit this request to the appropriate DEP Regional Office (see <http://www.mass.gov/dep/about/region/findyour.htm>).

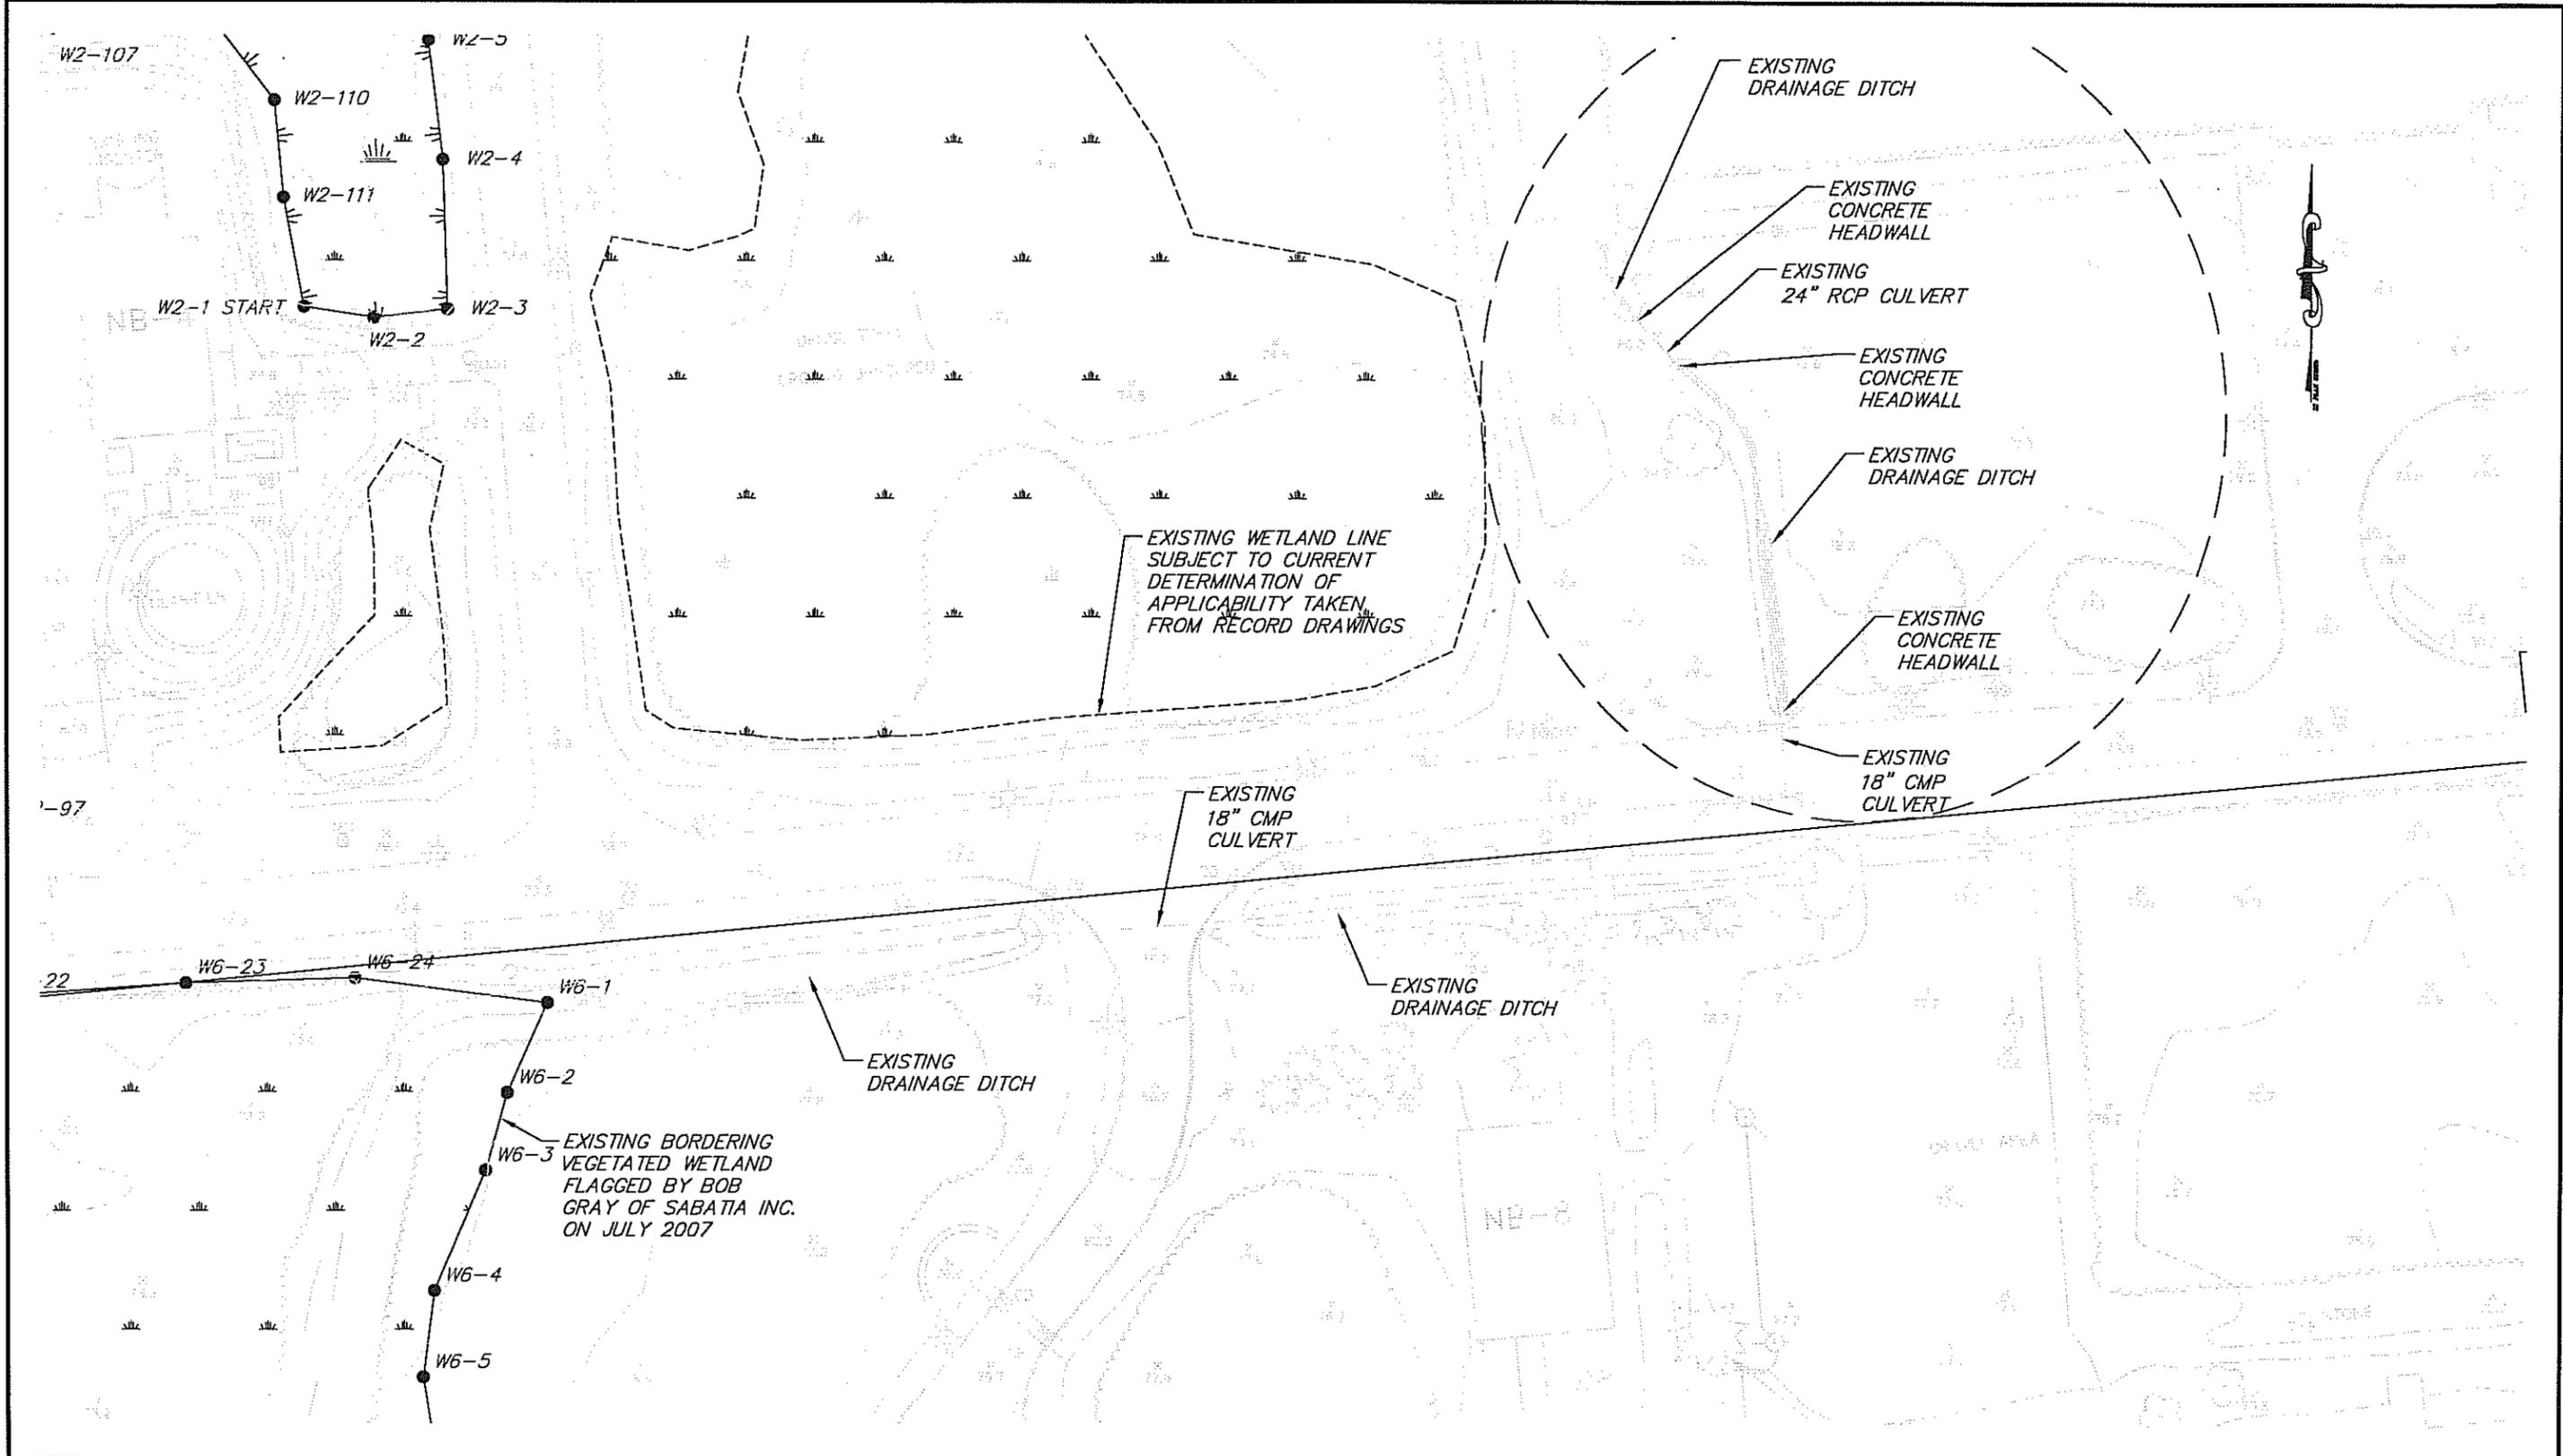

FIELD ENGINEERING CO., INC.
CONSULTING ENGINEERS

11D INDUSTRIAL DRIVE
P.O. BOX 1178
MATTAPOISETT, MA 02739
TEL: (508) 758-2749
FAX: (508) 758-2849

THE CROCKER BUILDING
4 COURT STREET SUITE 104
TAUNTON, MA 02780
TEL: (508) 824-9279
FAX: (508) 824-9276

**RECORD DRAWING
MULTILAYER COATING TECHNOLOGIES**

100 DUCHAINE BOULEVARD
NEW BEDFORD, MASSACHUSETTS

Project No.	1646	Date	12/4/09
Scale	1"=60'	Revised	3/21/14
Issued For	PERMITTING	Sheet	2 OF 2

1646_ND-EXHIBIT