

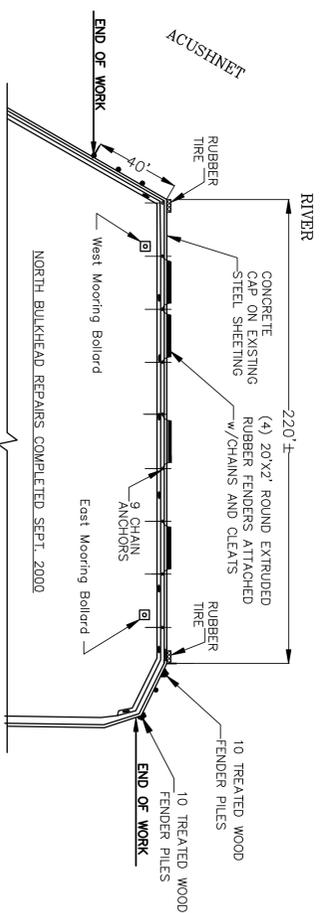


LOCUS MAP
N.T.S.

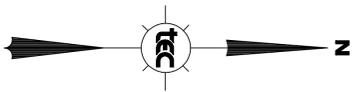

PLAN OF WORK PERFORMED
SCALE: 1" = 40'

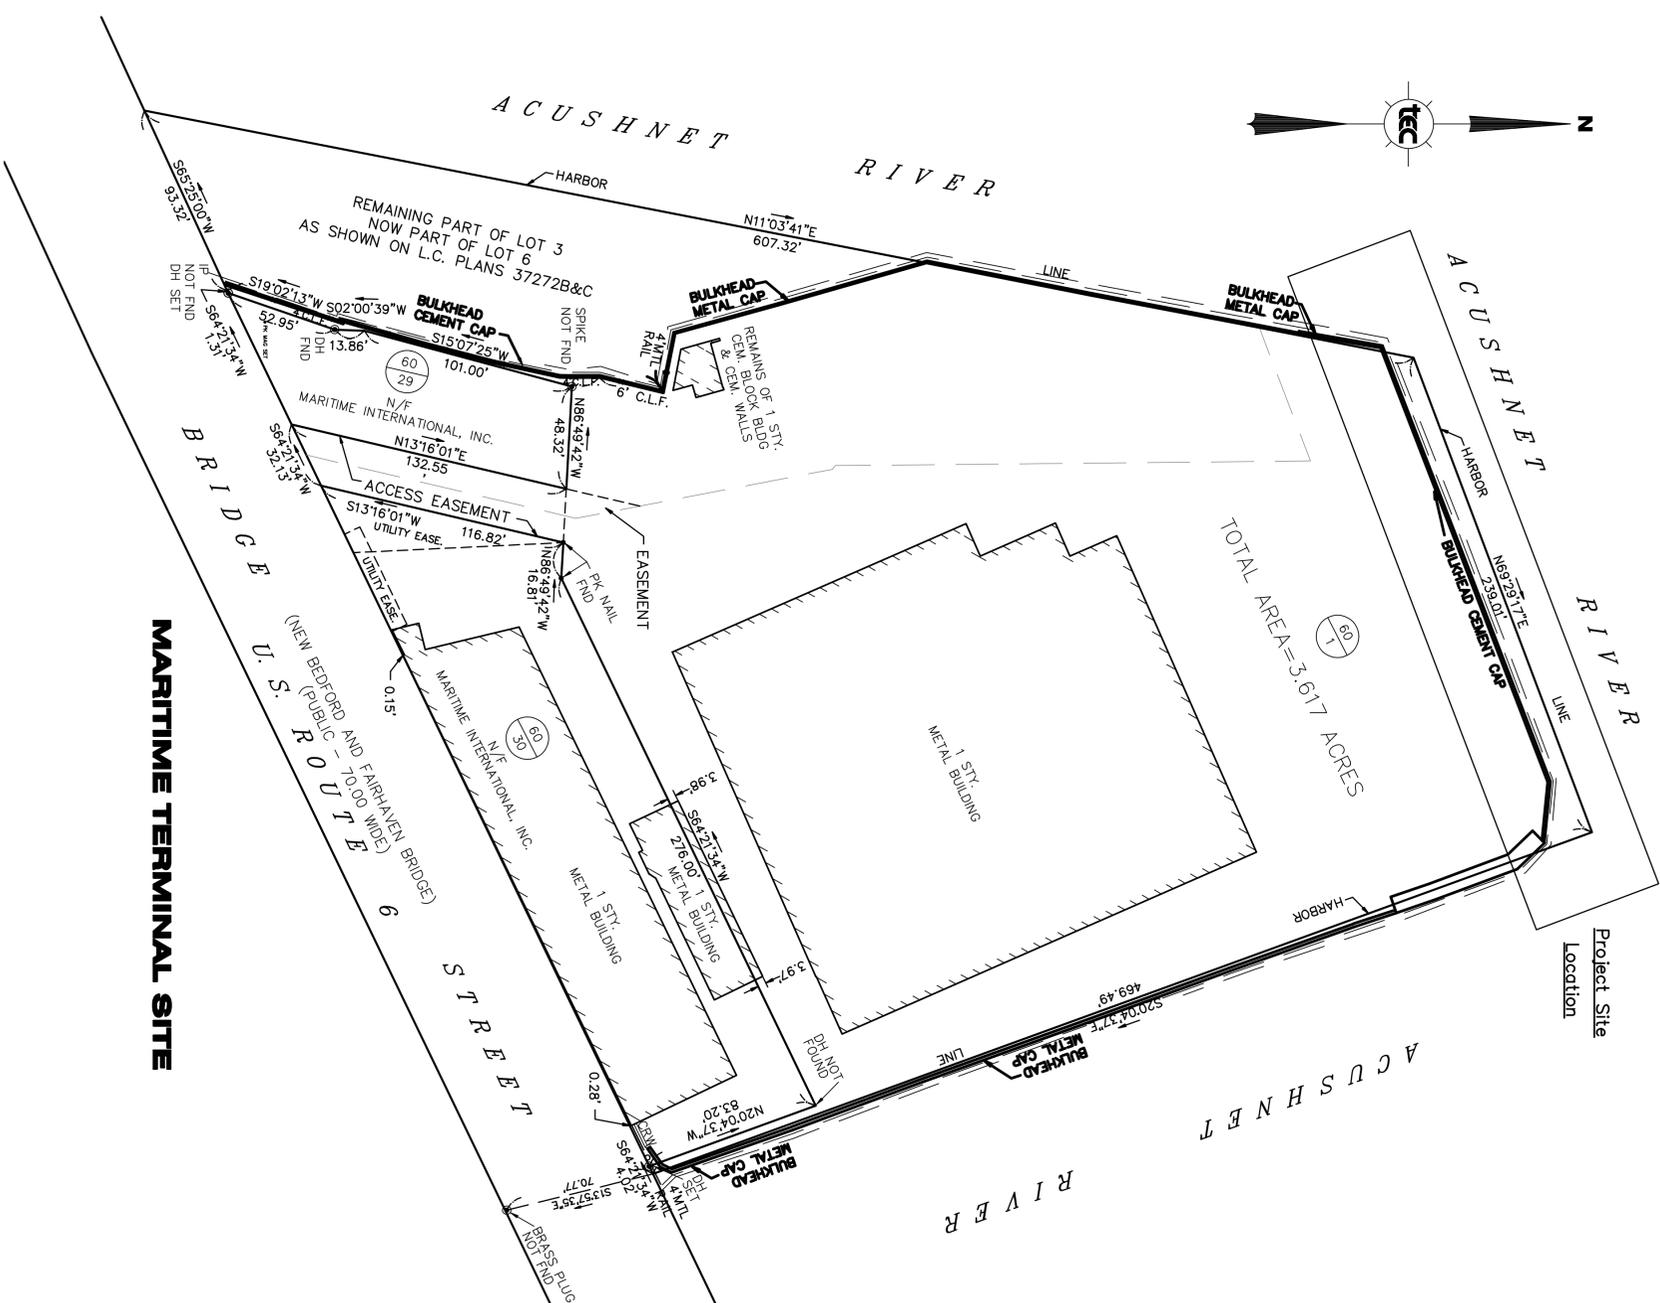

Project Site
Location

TEC tibbetts engineering corp
716 COUNTY STREET, TAUNTON, MA 02780
tel. (508) 852-4634 • fax (508) 853-7811
EMAIL: IR@tibbettsengineering.com
www.tibbettsengineering.com
civil engineering
land surveying
transportation
environmental permitting
testing & construction services

BEARING SYSTEM BASED UPON

PLAN REFERENCES

TITLE REFERENCES

Rev.	Date	Description	By



Project Location
**Bridge Street
(Fish Island)
New Bedford, MA,
(Bristol County)**

Prepared For
Maritime Terminal, Inc.

Drawing Title
**AS BUILT
Plan
of the
North End Bulkhead
Repairs
(made in Sept. 2000)**

COPYRIGHT © 2014 TIBBETTS ENGINEERING CORP.
NO PART OF THIS DRAWING MAY BE REPRODUCED,
TRANSMITTED, OR STORED BY ANY MEANS, WHAT-
SOEVER, WITHOUT THE EXPRESSED WRITTEN CON-
SENT OF TIBBETTS ENGINEERING CORP. ANY
DATE EXCEPTION TO ANY REPRODUCING AUTHORITY
WHICH MAY REPRODUCE IT IN CONNECTION WITH
THE PERFORMANCE OF OFFICIAL BUSINESS UNDER
ITS JURISDICTION.

Drawn by: C.W.
Design by: C.W.
Reviewed by: W.G.
Approved by: C.W.
Project No: 9064.210
Date: 07-17-2014

Drawing Number
1 of 1