


PHILLIPS ~PUBLIC - VARIABLE WIDTH~ ROAD

NOTES:

FINAL ASBUILT SURVEY PERFORMED BY FARLAND CORP. IN JANUARY 2019.

COPYRIGHT © 2016 FARLAND CORP. ALL RIGHTS RESERVED.
NO PART OF THIS DOCUMENT MAY BE REPRODUCED, STORED IN A RETRIEVAL SYSTEM, OR TRANSMITTED IN ANY FORM OR BY ANY MEANS, ELECTRONIC, MECHANICAL, PHOTOCOPYING, RECORDING OR OTHERWISE, WITHOUT THE EXPRESS WRITTEN CONSENT OF FARLAND CORP.
ANY MODIFICATIONS MADE TO THIS DOCUMENT WITHOUT THE WRITTEN PERMISSION OF FARLAND CORP. SHALL RENDER IT INVALID AND UNUSABLE.

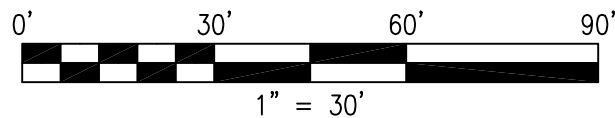

FINAL AS-BUILT PLAN
1703 PHILLIPS ROAD
ASSESSORS MAP 134 LOT 474
NEW BEDFORD, MASSACHUSETTS



www.FarlandCorp.com

401 COUNTY STREET
NEW BEDFORD, MA 02740
P.508.717.3479
OFFICES IN:
● TAUNTON
● MARLBOROUGH
● WARWICK, RI

RECORD OWNER:
ASSESSORS MAP 134 LOT 474
ASPEN PROPERTIES HOLDINGS, LLC
60 COURT STREET
TAUNTON, MA 02780
LC CERT# 24385



SCALE: 1"=30'

JANUARY 31, 2019

JOB NO: 17-1205.3