

# **Invitation for Bid #15439033 New Bedford MA**

## **Aluminum Picket Guardrail**

### **ADDENDUM # 2 November 10, 2014**

It has come to the attention of the City of New Bedford that there are additions, questions or comments concerning the IFB for this project that should be addressed and shared with all the prospective vendors who will be submitting a proposal. The following shall be incorporated into the subject Invitation for Bid # 15439033 for Aluminum Picket Guardrail.


#### **Addition # 1: Time Extension for Bid**

In an effort to provide sufficient time for review of the as-built information being sent with this addendum, the Bid Date for this procurement will be postponed to Thursday November 20, 2014 at 2:00 PM in accordance with other criteria in the Invitation for Bid document.


#### **Addition # 2: As-Built Survey of East Rodney French Blvd Barrier Walkway**

In an effort to provide as much information as possible to the prospective vendors, an as-built drawing accompanies this addendum. The as-built information includes locations of the PVC conduit projections and electrical hand-holes (for electrical lighting) along the landward side of the walkway and intermediate points along the edge of the walkway along both sides that will enable establishing the actual edge conditions of the walkway. These points were located by instrument survey and are believed to be sufficient in accuracy with reference to horizontal and vertical reference to allow the vendor to estimate the necessary horizontal deflections and vertical curves along the walkway and determine the level of overall customization needed for bidding purposes. There is an expectation that further field measurements performed by the vendor will be needed to obtain greater detail to establish the final layout and detailing of the guardrail the cost of which should be included in the vendor's bid.

\*\* Bidders are advised that the "as built" drawings are available in different formats for their convenience.

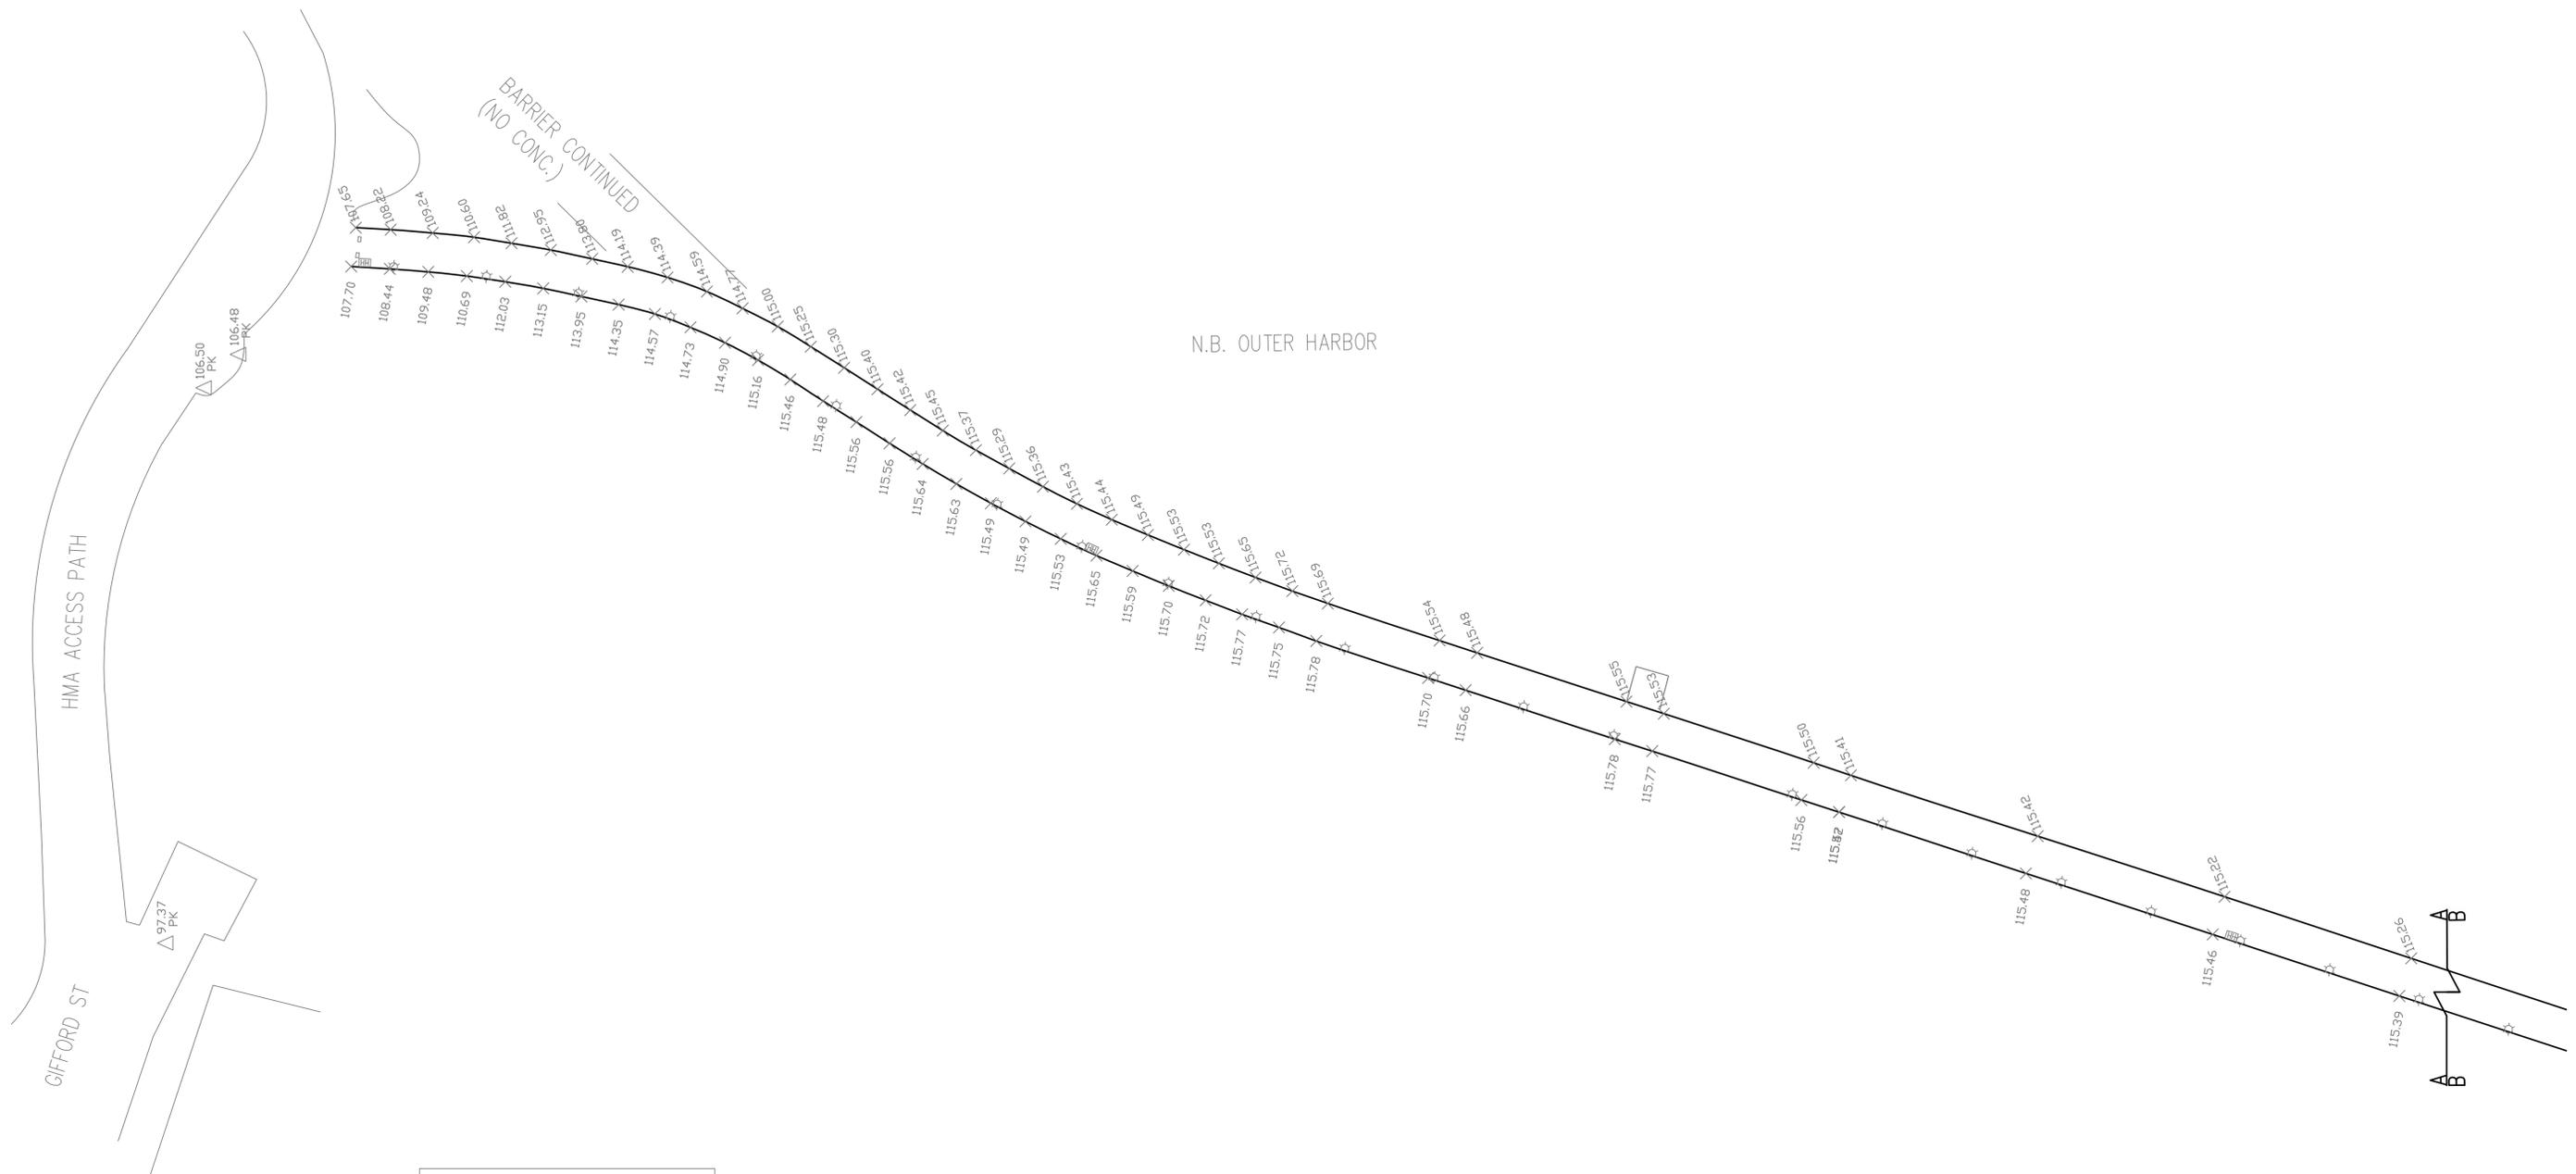

LEGEND	
x	Edge of Conc. Locations w/ Elevations
△	Benchmarks w/ Elevation
☉	Light Post Center Location of Conduit
HH	Hand Hole Boxes

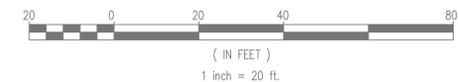


**AS-BUILT**


**CITY OF NEW BEDFORD**  
DEPARTMENT OF PUBLIC INFRASTRUCTURE

**Hurricane Barrier Access Walk**

SURVEYED BY : JG, JD	SCALE: 1" = 20'
DRAWN BY : JG, SD	DATE : NOVEMBER 2014

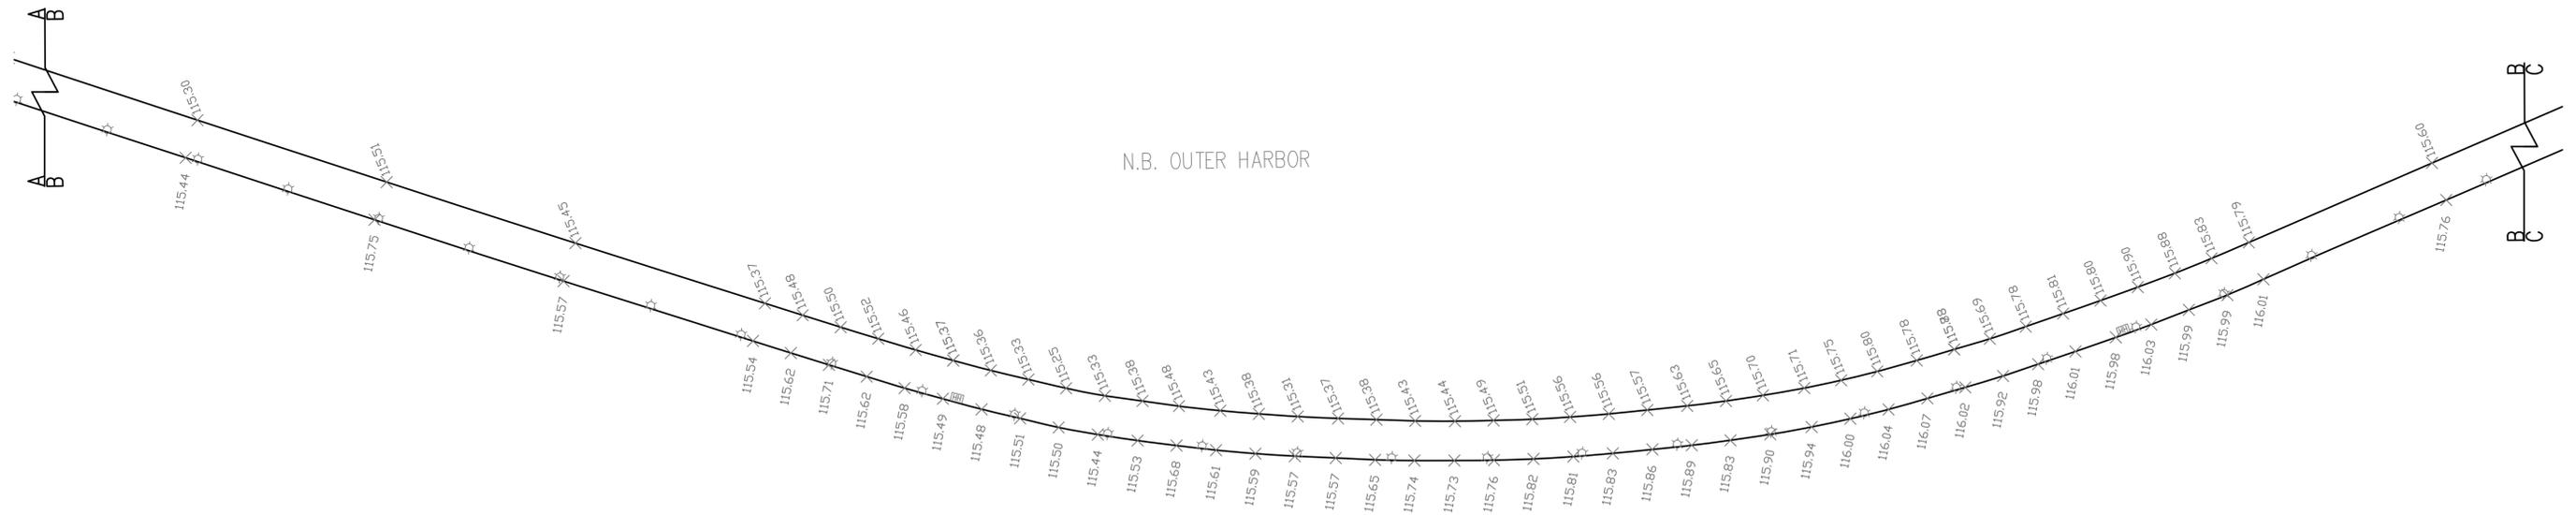


LEGEND	
×	Edge of Conc. Locations w/ Elevations
Δ	Benchmarks w/ Elevation
☉	Light Post Center Location of Conduit
HH	Hand Hole Boxes

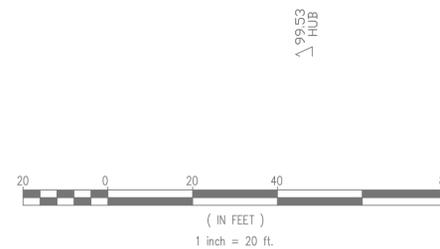

△ 99.53  
HUB

AS-BUILT	
CITY OF NEW BEDFORD DEPARTMENT OF PUBLIC INFRASTRUCTURE	
Hurricane Barrier Access Walk	
SURVEYED BY : JG, JD DRAWN BY : JG, SD	SCALE: 1" = 20' DATE : NOVEMBER 2014

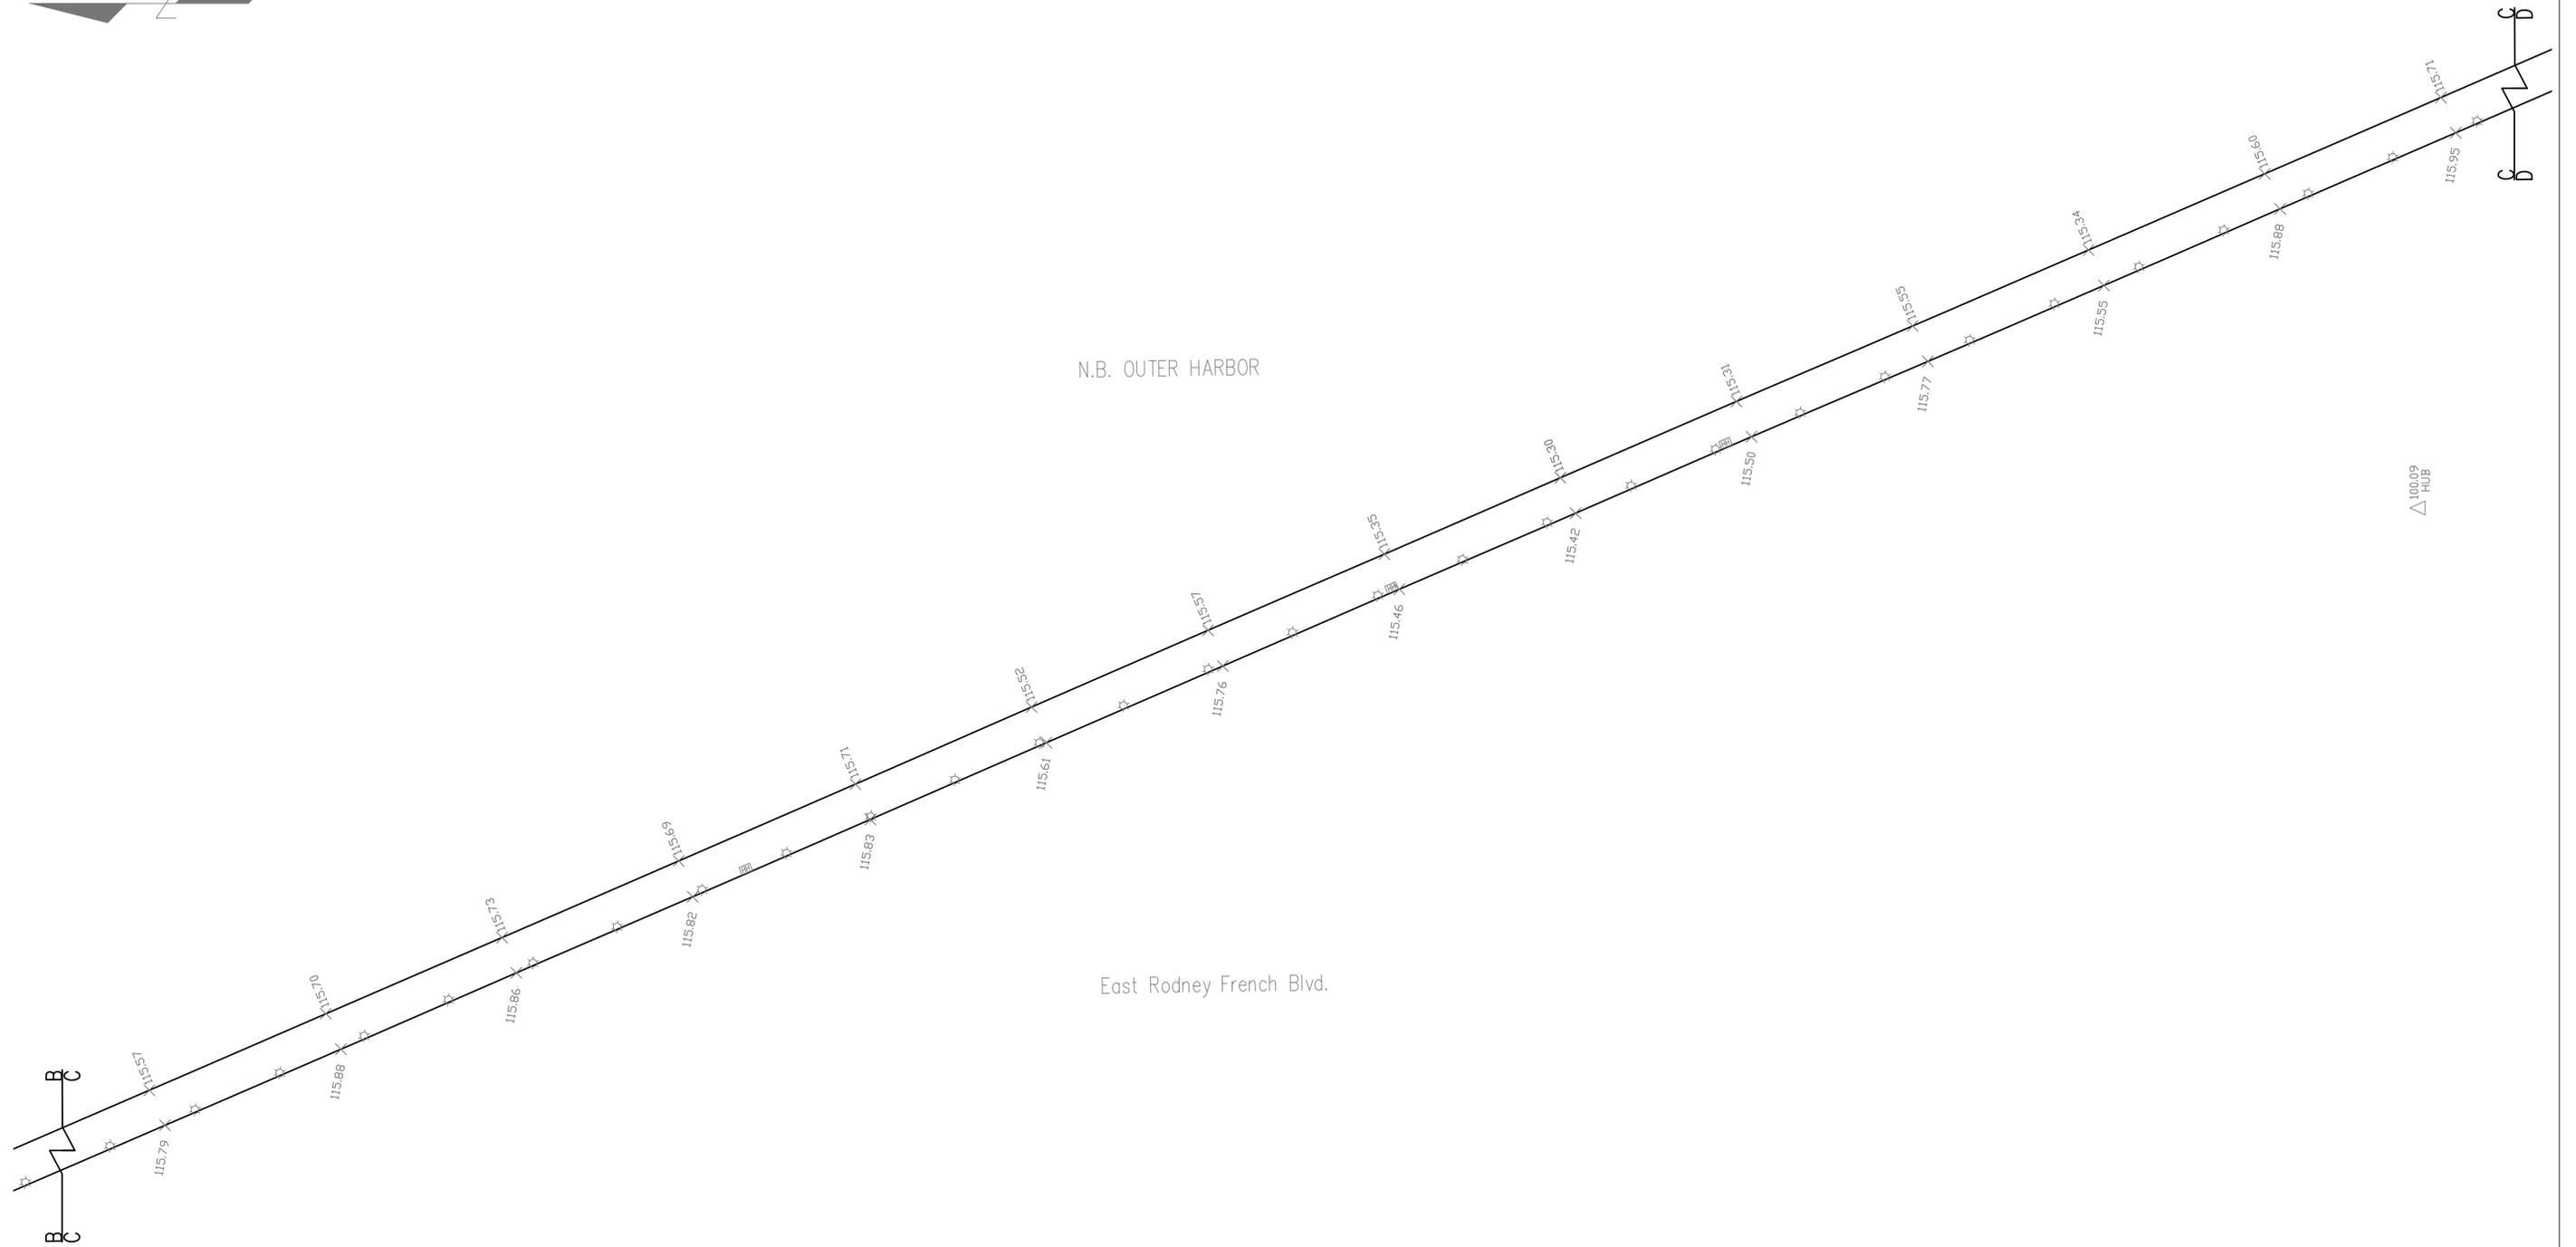

LEGEND	
×	Edge of Conc. Locations w/ Elevations
Δ	Benchmarks w/ Elevation
☉	Light Post Center Location of Conduit
HH	Hand Hole Boxes



**AS-BUILT**

**CITY OF NEW BEDFORD**  
DEPARTMENT OF PUBLIC INFRASTRUCTURE


**Hurricane Barrier Access Walk**

SURVEYED BY : JG, JD	SCALE: 1" = 20'
DRAWN BY : JG, SD	DATE : NOVEMBER 2014



N.B. OUTER HARBOR

East Rodney French Blvd.

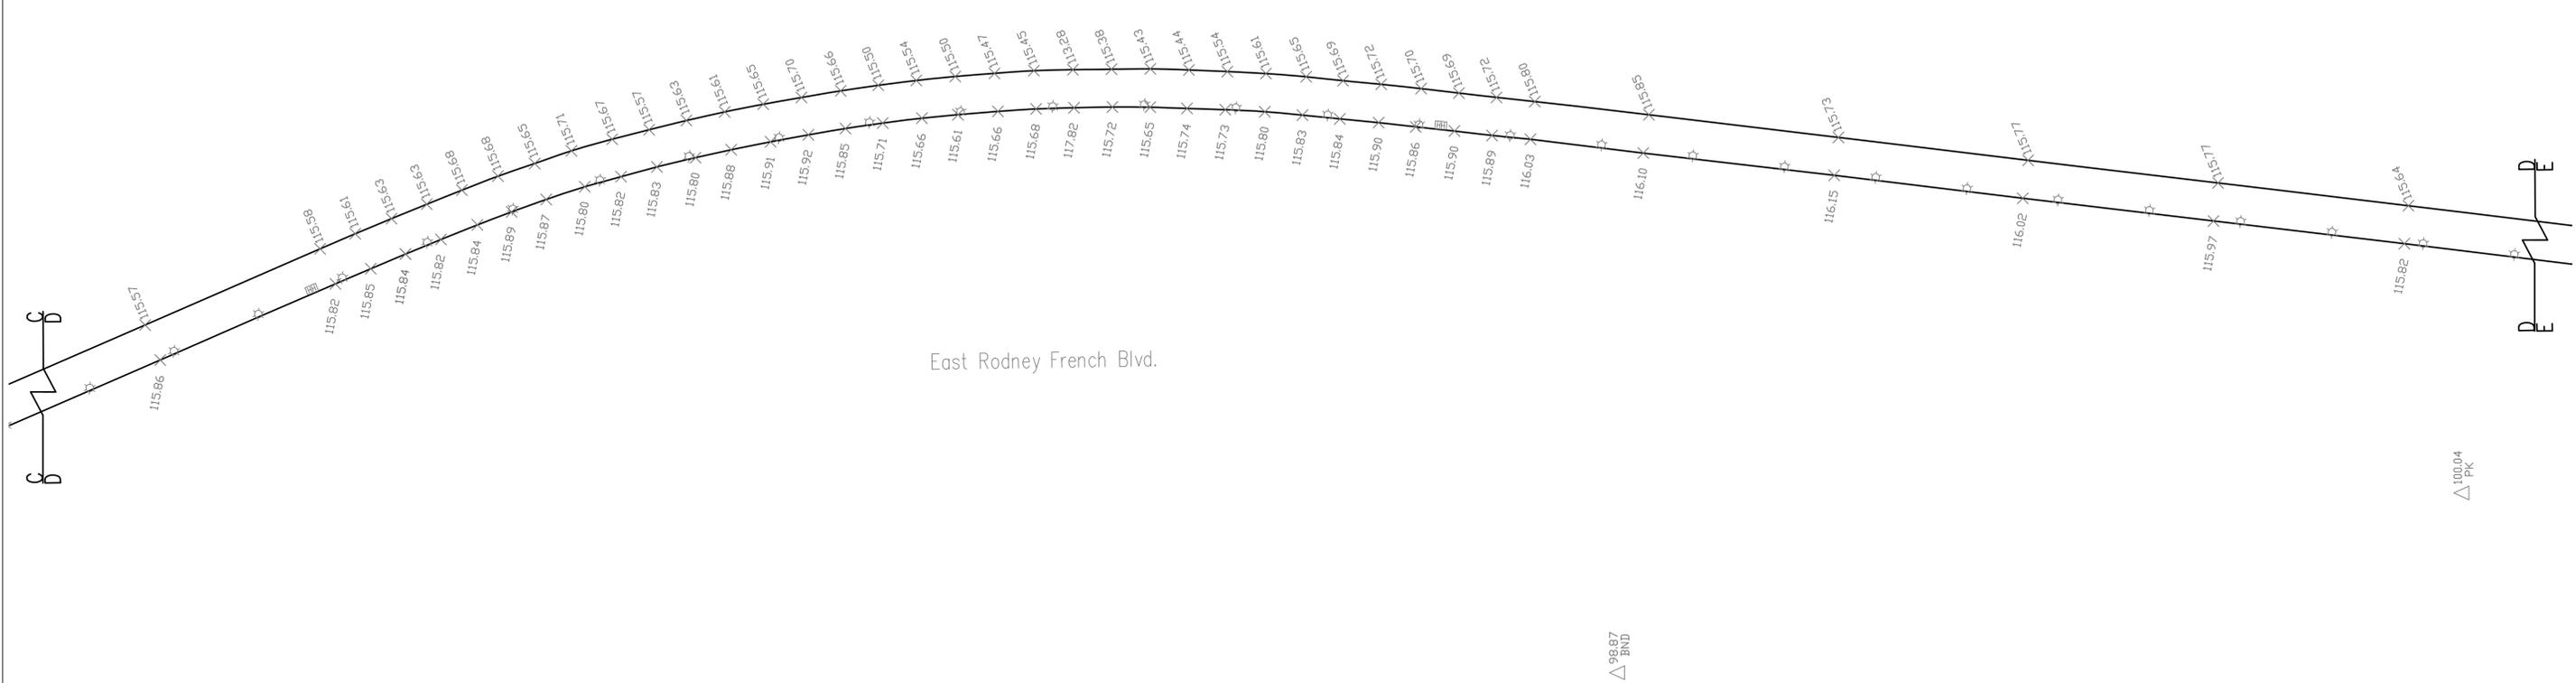

LEGEND	
×	Edge of Conc. Locations w/ Elevations
Δ	Benchmarks w/ Elevation
☉	Light Post Center Location of Conduit
HH	Hand Hole Boxes




**AS-BUILT**

**CITY OF NEW BEDFORD**  
DEPARTMENT OF PUBLIC INFRASTRUCTURE

**Hurricane Barrier Access Walk**


SURVEYED BY : JG, JD	SCALE: 1" = 20'
DRAWN BY : JG, SD	DATE : NOVEMBER 2014

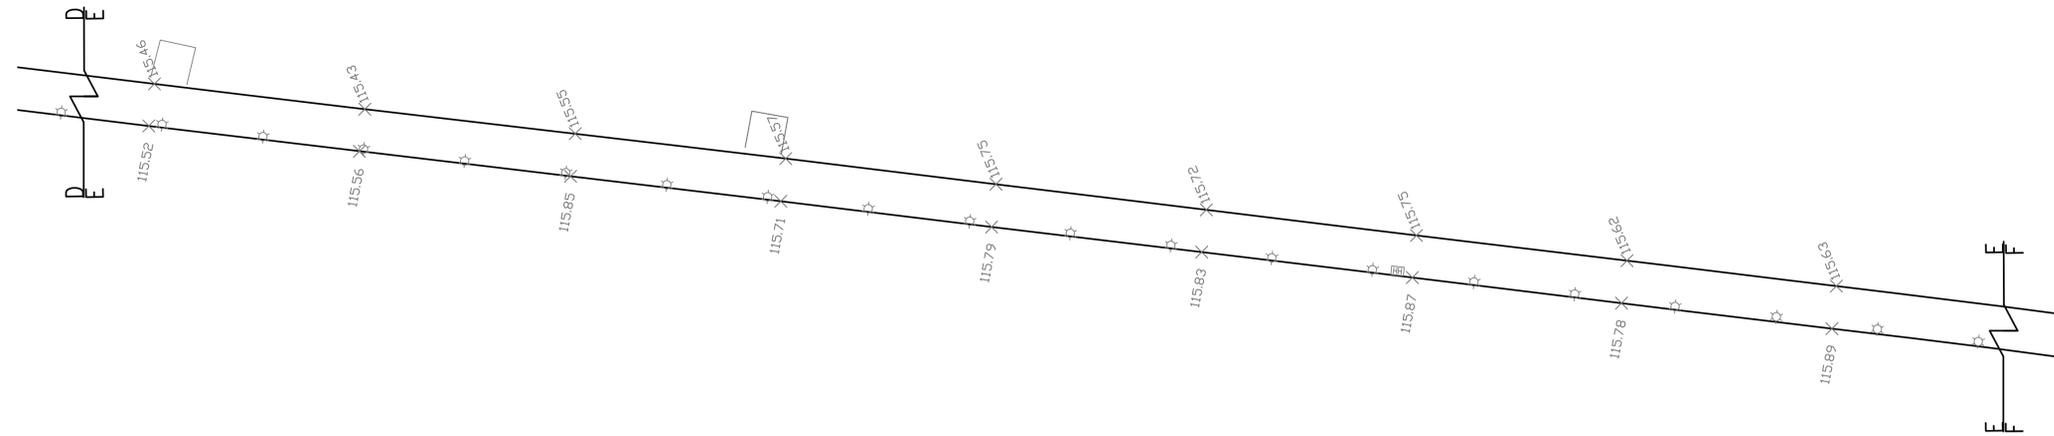

LEGEND	
×	Edge of Conc. Locations w/ Elevations
Δ	Benchmarks w/ Elevation
☼	Light Post Center Location of Conduit
HH	Hand Hole Boxes



AS-BUILT	
CITY OF NEW BEDFORD DEPARTMENT OF PUBLIC INFRASTRUCTURE	
Hurricane Barrier Access Walk	
SURVEYED BY : JG, JD DRAWN BY : JG, SD	SCALE: 1" = 20' DATE : NOVEMBER 2014

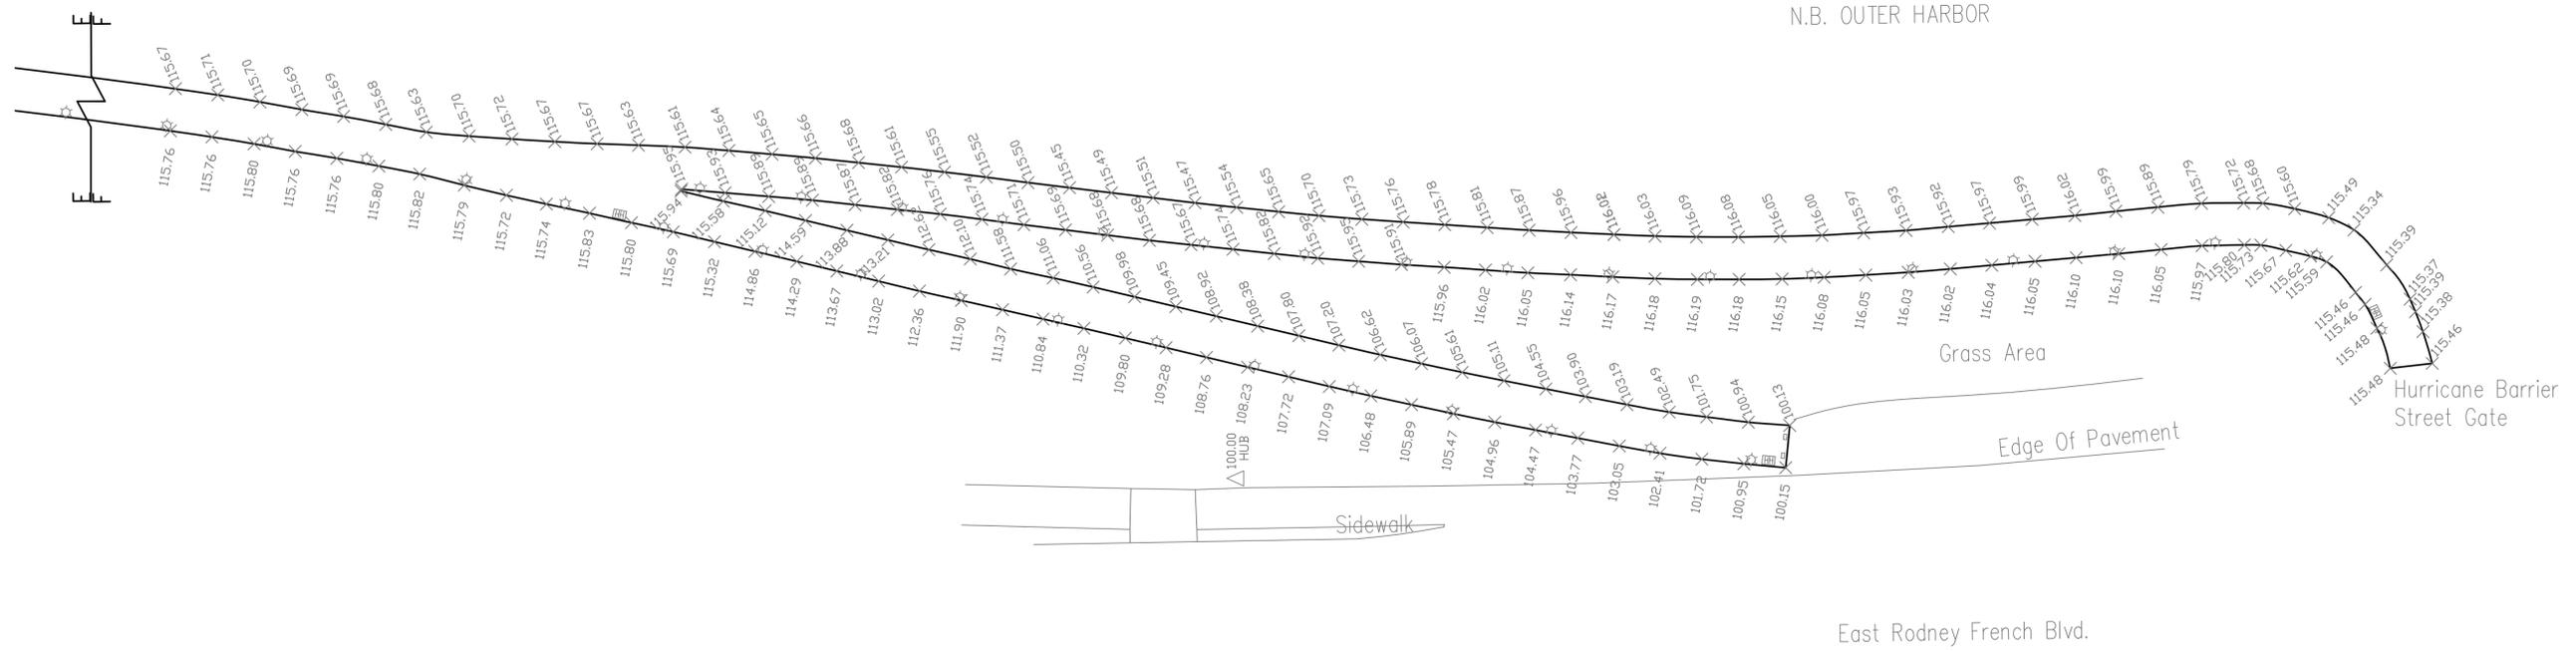

LEGEND	
×	Edge of Conc. Locations w/ Elevations
△	Benchmarks w/ Elevation
☉	Light Post Center Location of Conduit
HH	Hand Hole Boxes



AS-BUILT	
CITY OF NEW BEDFORD	
DEPARTMENT OF PUBLIC INFRASTRUCTURE	
Hurricane Barrier Access Walk	
SURVEYED BY : JG, JD	SCALE: 1" = 20'
DRAWN BY : JG, SD	DATE : NOVEMBER 2014