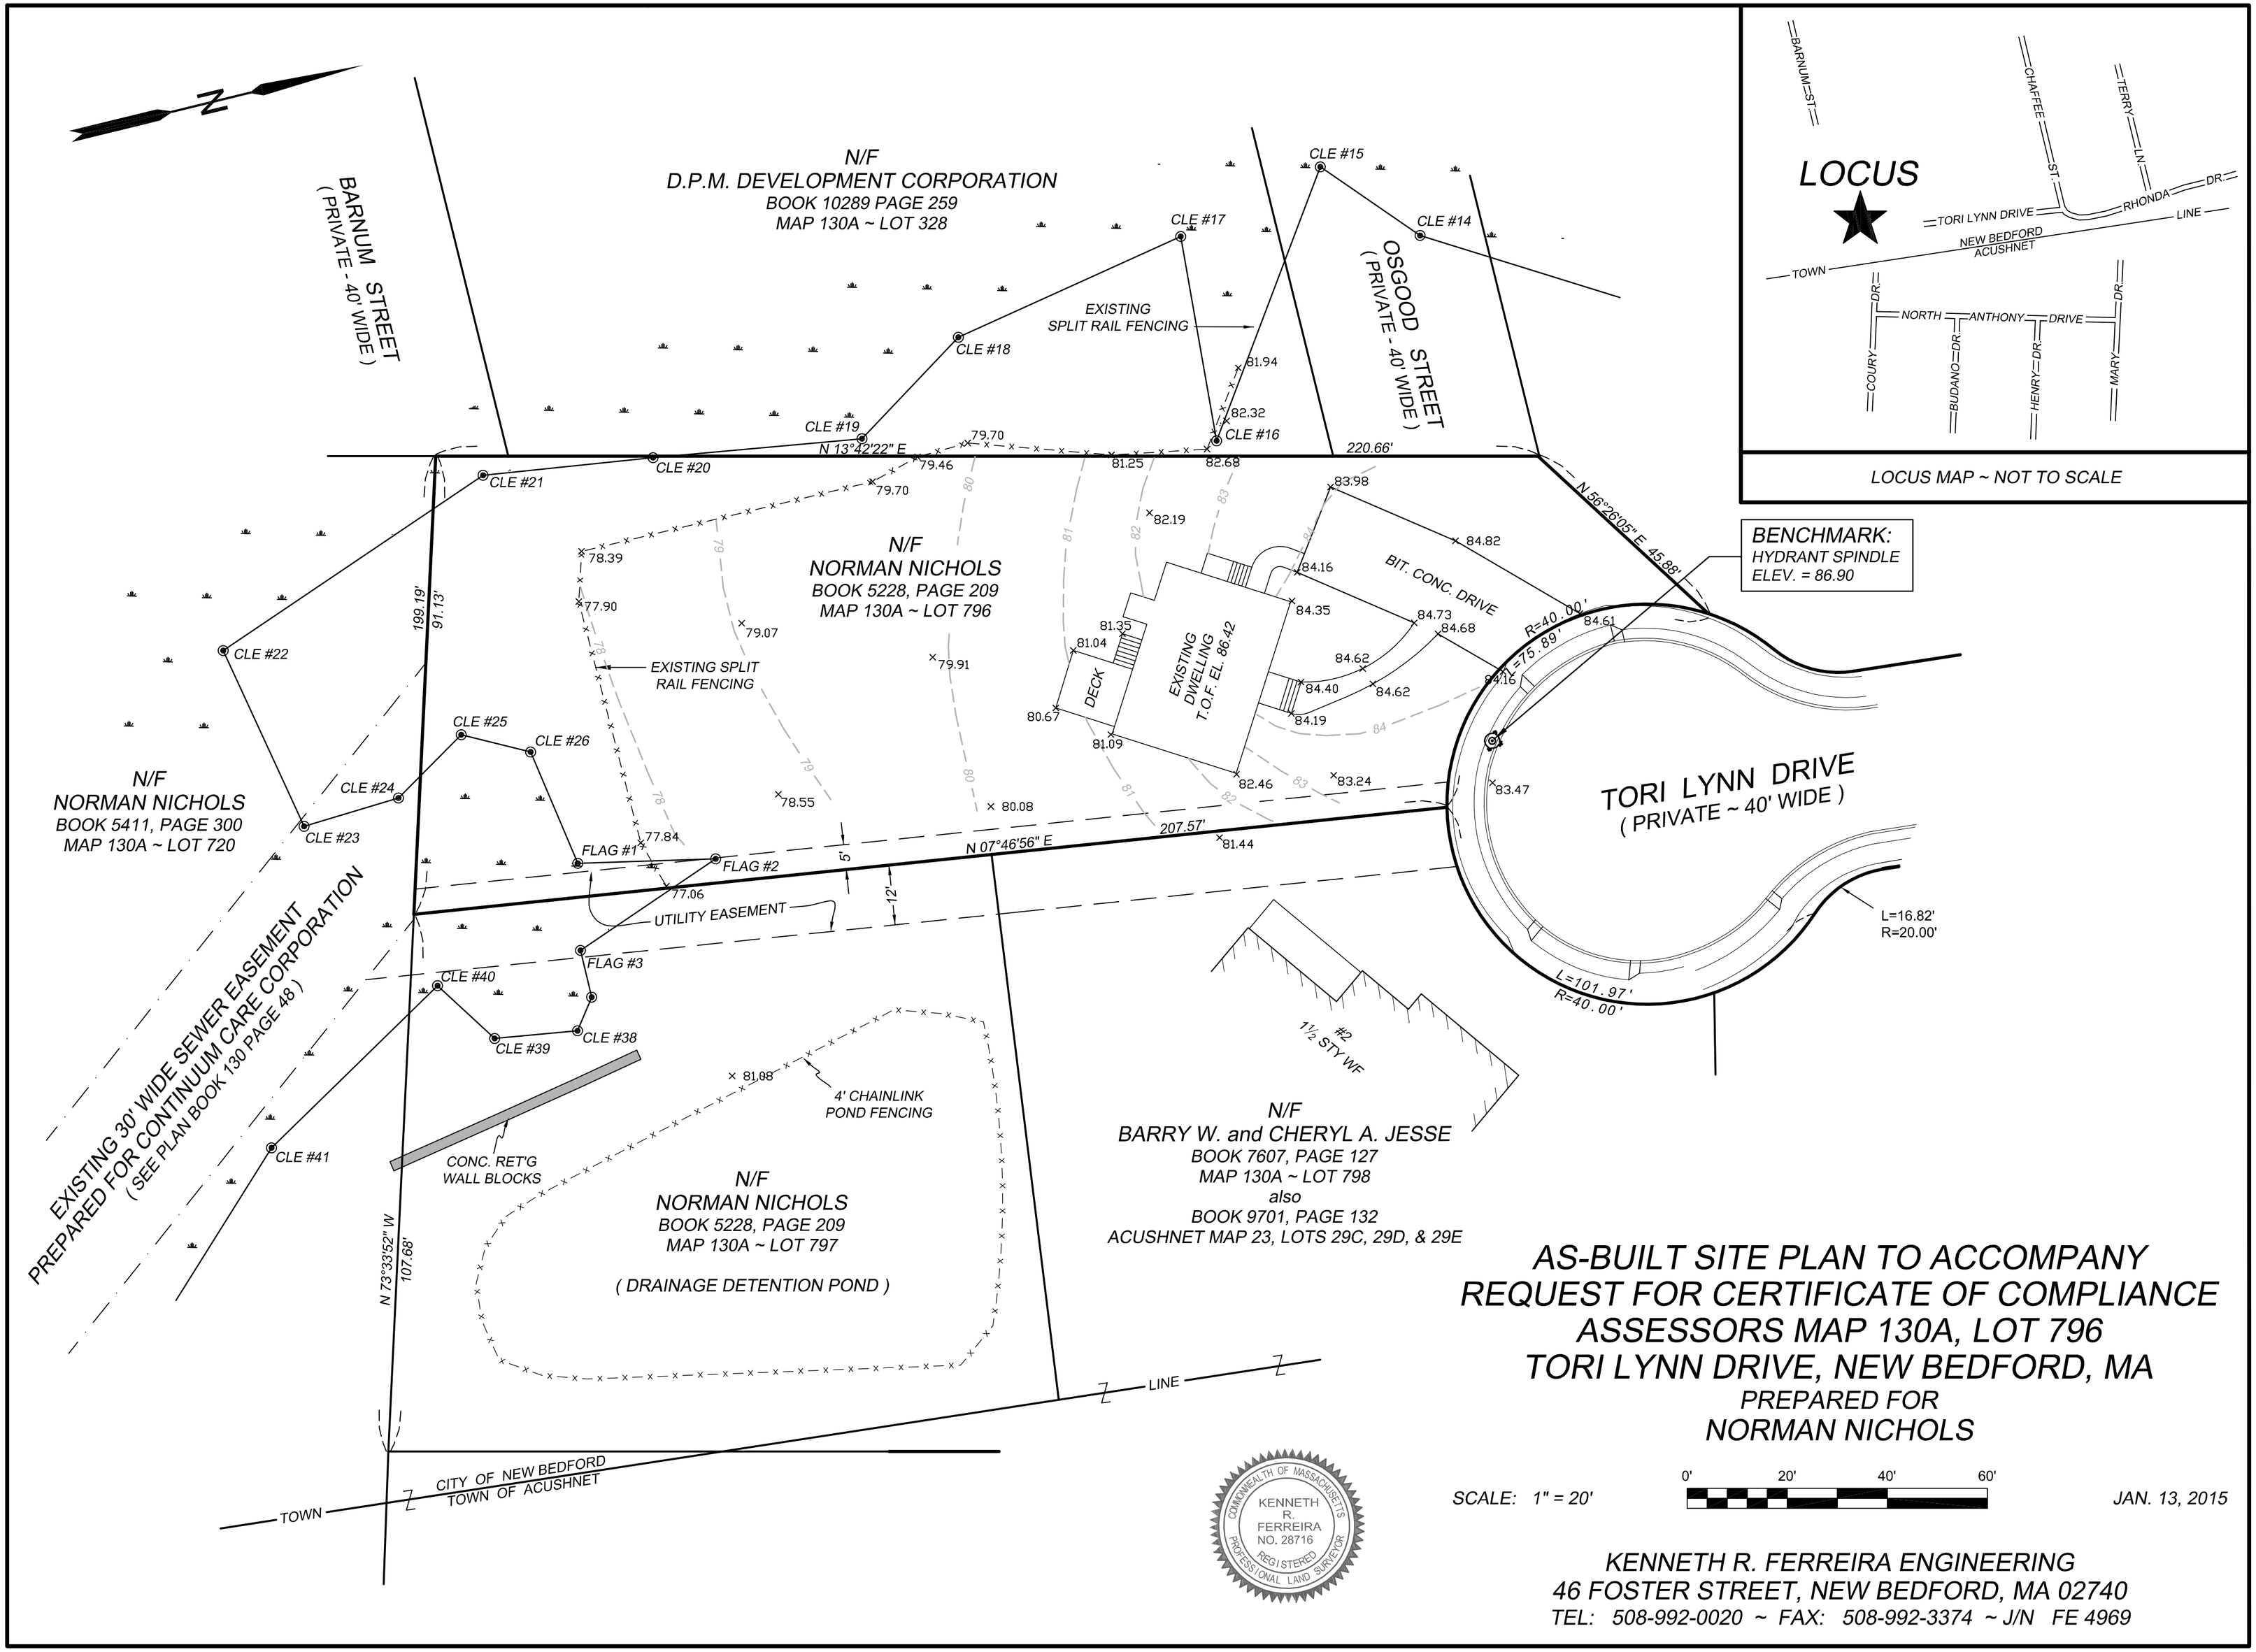

AS-BUILT SITE PLAN TO ACCOMPANY REQUEST FOR CERTIFICATE OF COMPLIANCE
ASSESSORS MAP 130A, LOT 796
TORI LYNN DRIVE, NEW BEDFORD, MA

PREPARED FOR

NORMAN NICHOLS

SCALE: 1" = 20'

JAN. 13, 2015

KENNETH R. FERREIRA ENGINEERING
46 FOSTER STREET, NEW BEDFORD, MA 02740
TEL: 508-992-0020 ~ FAX: 508-992-3374 ~ J/N FE 4969