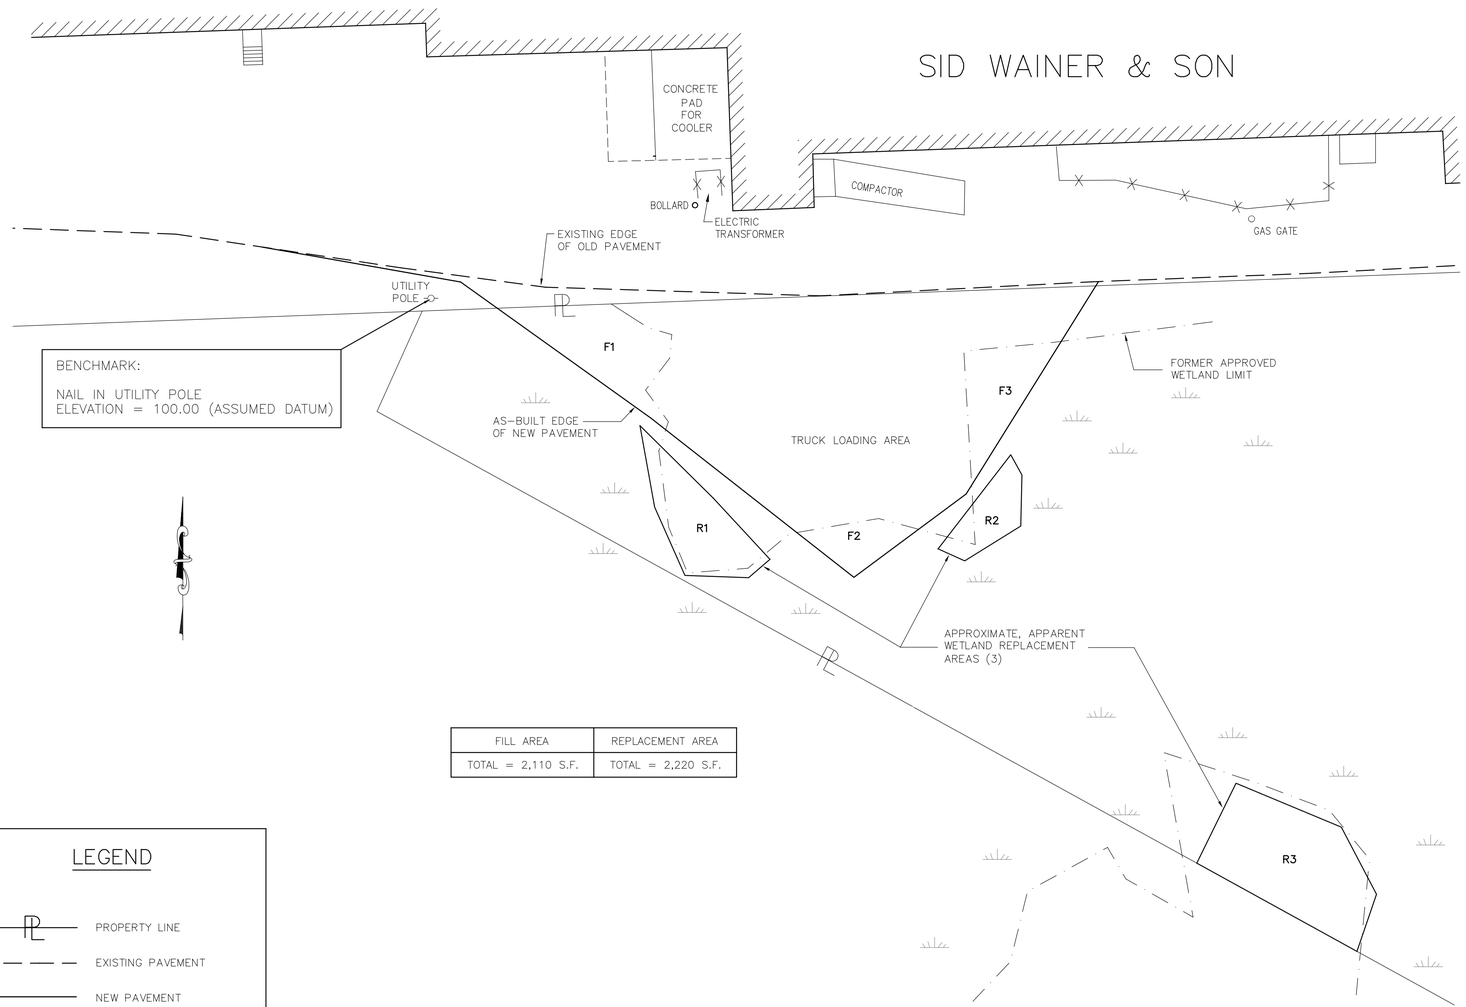

FILL AREA	REPLACEMENT AREA
TOTAL = 2,110 S.F.	TOTAL = 2,220 S.F.

LEGEND

- PROPERTY LINE
- EXISTING PAVEMENT
- NEW PAVEMENT
- WETLANDS LIMIT
- EDGE OF BUILDING
- CHAINLINK FENCE

20 0 10 20 40

SCALE IN FEET

SITE LOCUS

SCALE: 1"=2000'

AS-BUILT PLAN SHOWING TRUCK LOADING AREA AND WETLAND REPLACEMENT AREAS

PLAT 97, LOTS 6 & 9

NEW BEDFORD, MA

PREPARED FOR

FRIENDS REALTY, INC.

SCALE: 1" = 20' DATE: JANUARY 19, 2016

PREPARED BY

Boucher & Heureux, Inc.

CIVIL ENGINEERS LAND SURVEYORS

648 AMERICAN LEGION HIGHWAY, SUITE ONE
WESTPORT, MASSACHUSETTS 02790
tel. (508) 636-5905 – fax. (508) 636-2477

COPYRIGHT © 2004 BOUCHER & HEUREUX, INC. FILE: 1296-02