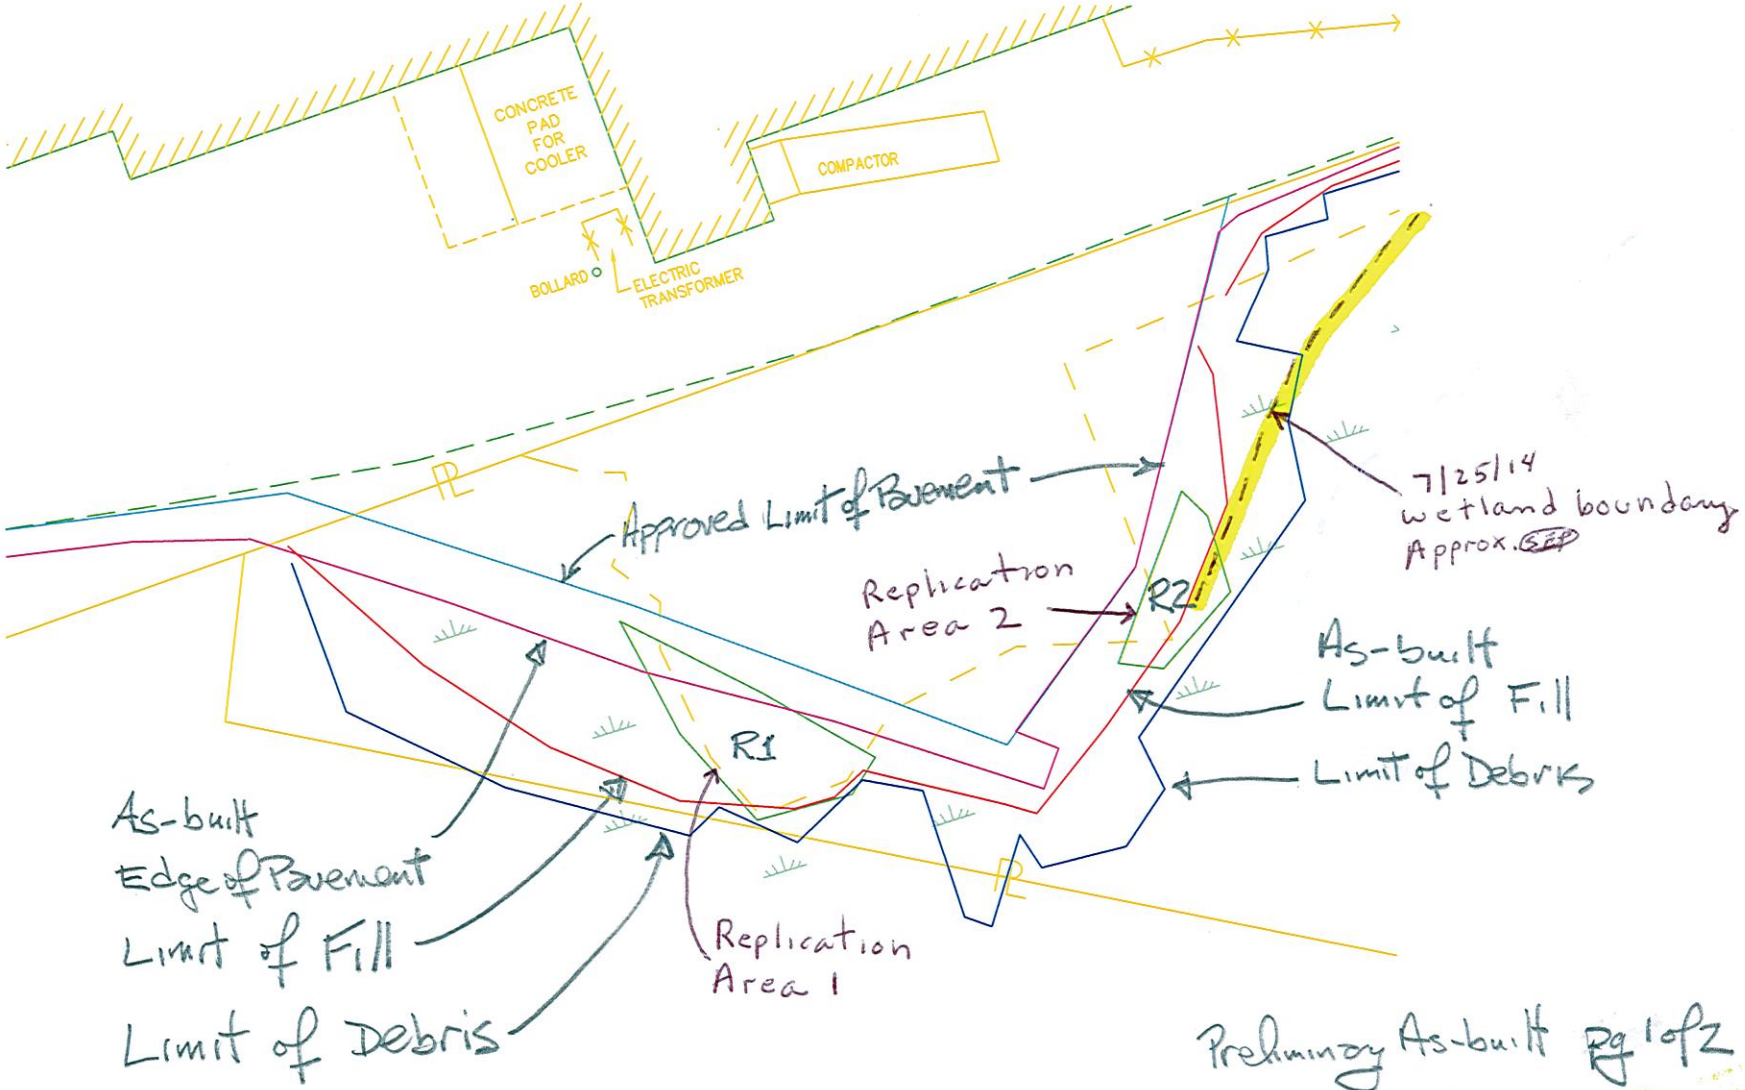

Preliminary As-built Pg 1 of 2

Friends Realty Inc

BOUCHER & HEUREUX, INC.
648 American Legion Hwy.
Westport, MA 02790

N.T.S.

March 1, 2014

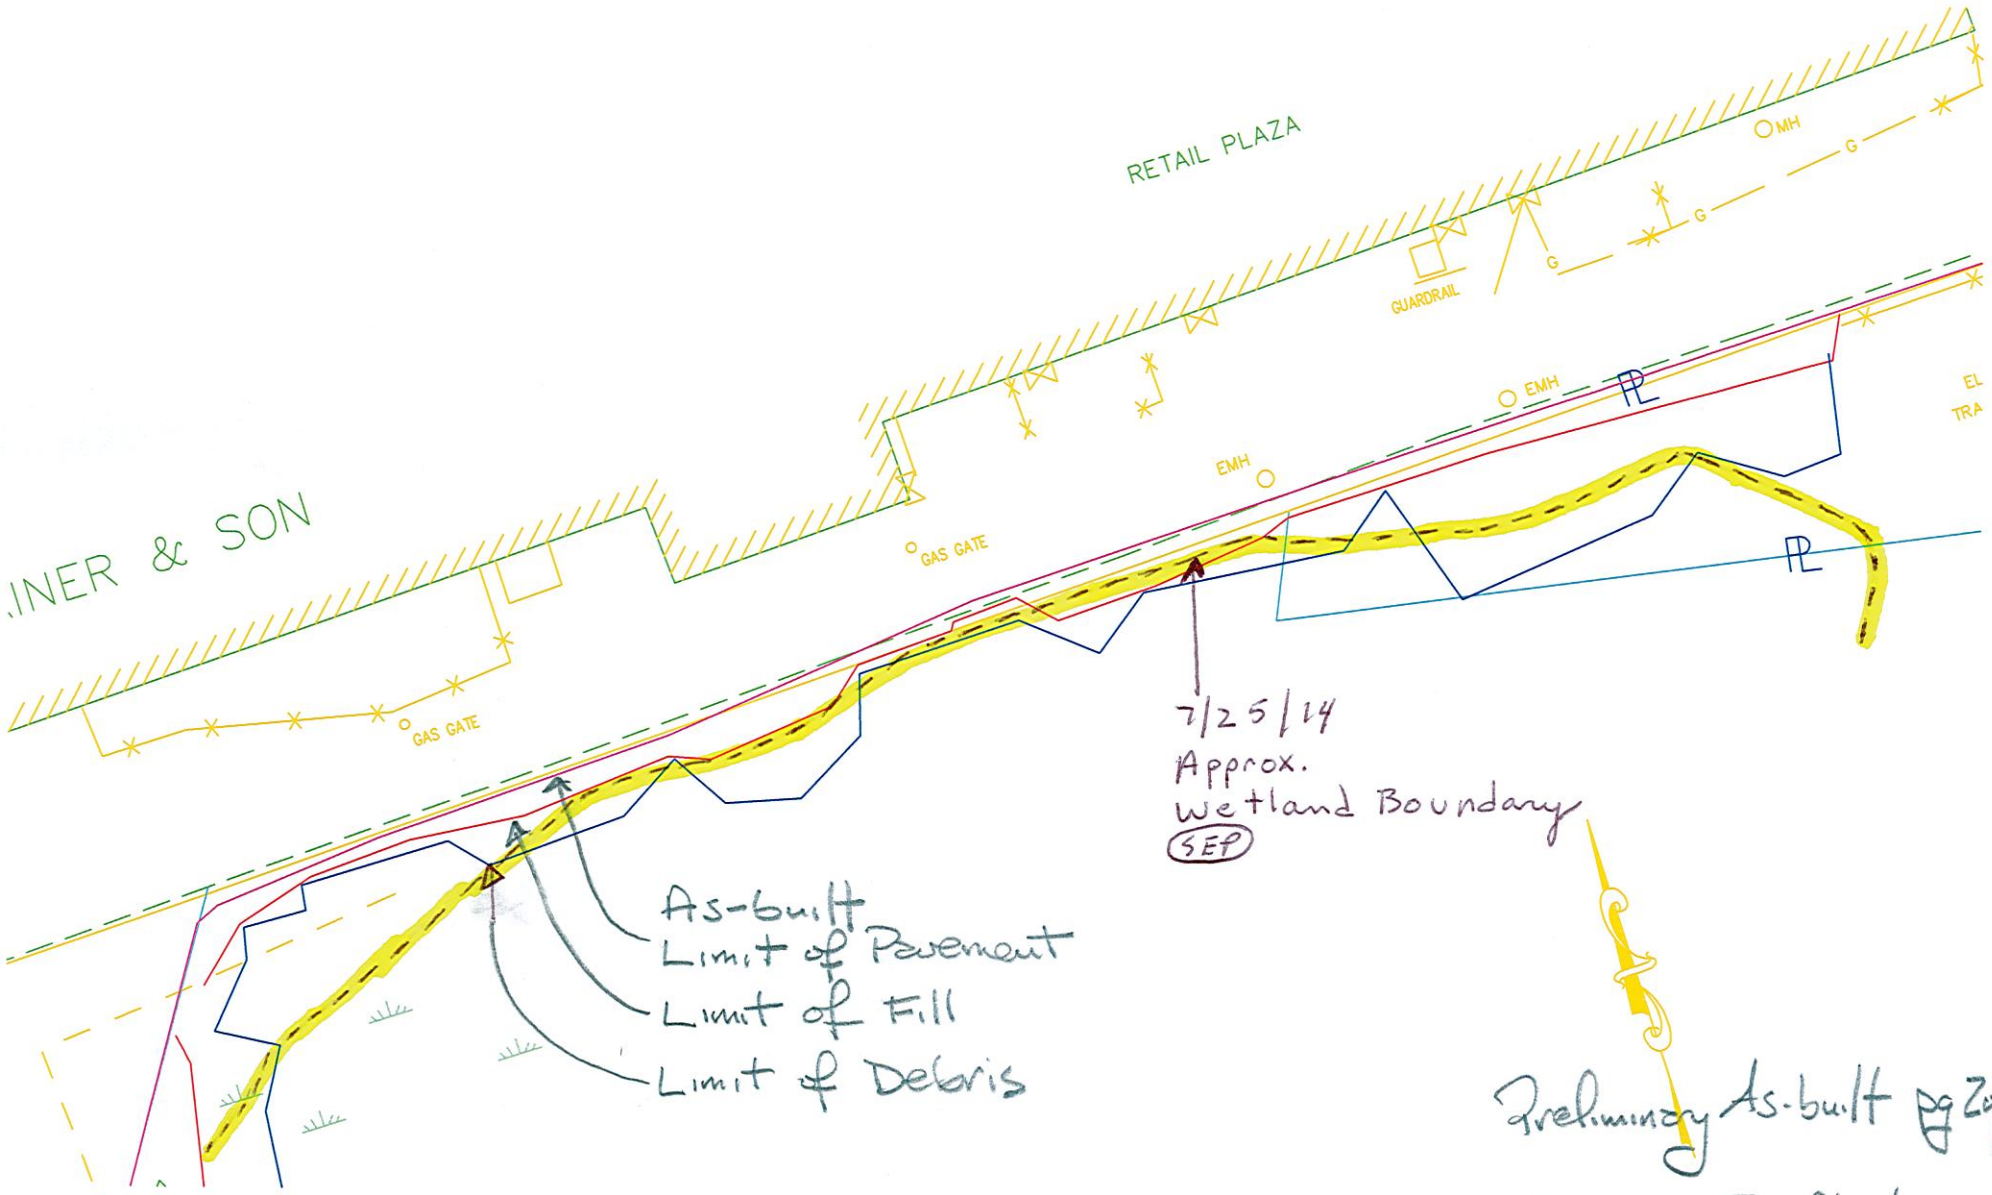

Preliminary As-built pg 2 of 2

Friends Realty Inc

BOUCHER & HEUREUX, INC.
648 American Legion Hwy.
Westport, MA 02790

N.T.S.

March 1, 2016